


This document, together with the concepts and designs presented herein, is intended only for the specific purpose and client for which it was prepared. Reuse of and improper reliance on this document without written authorization and adaptation by Kimley-Horn and Associates, Inc. shall be without liability to Kimley-Horn and Associates, Inc.

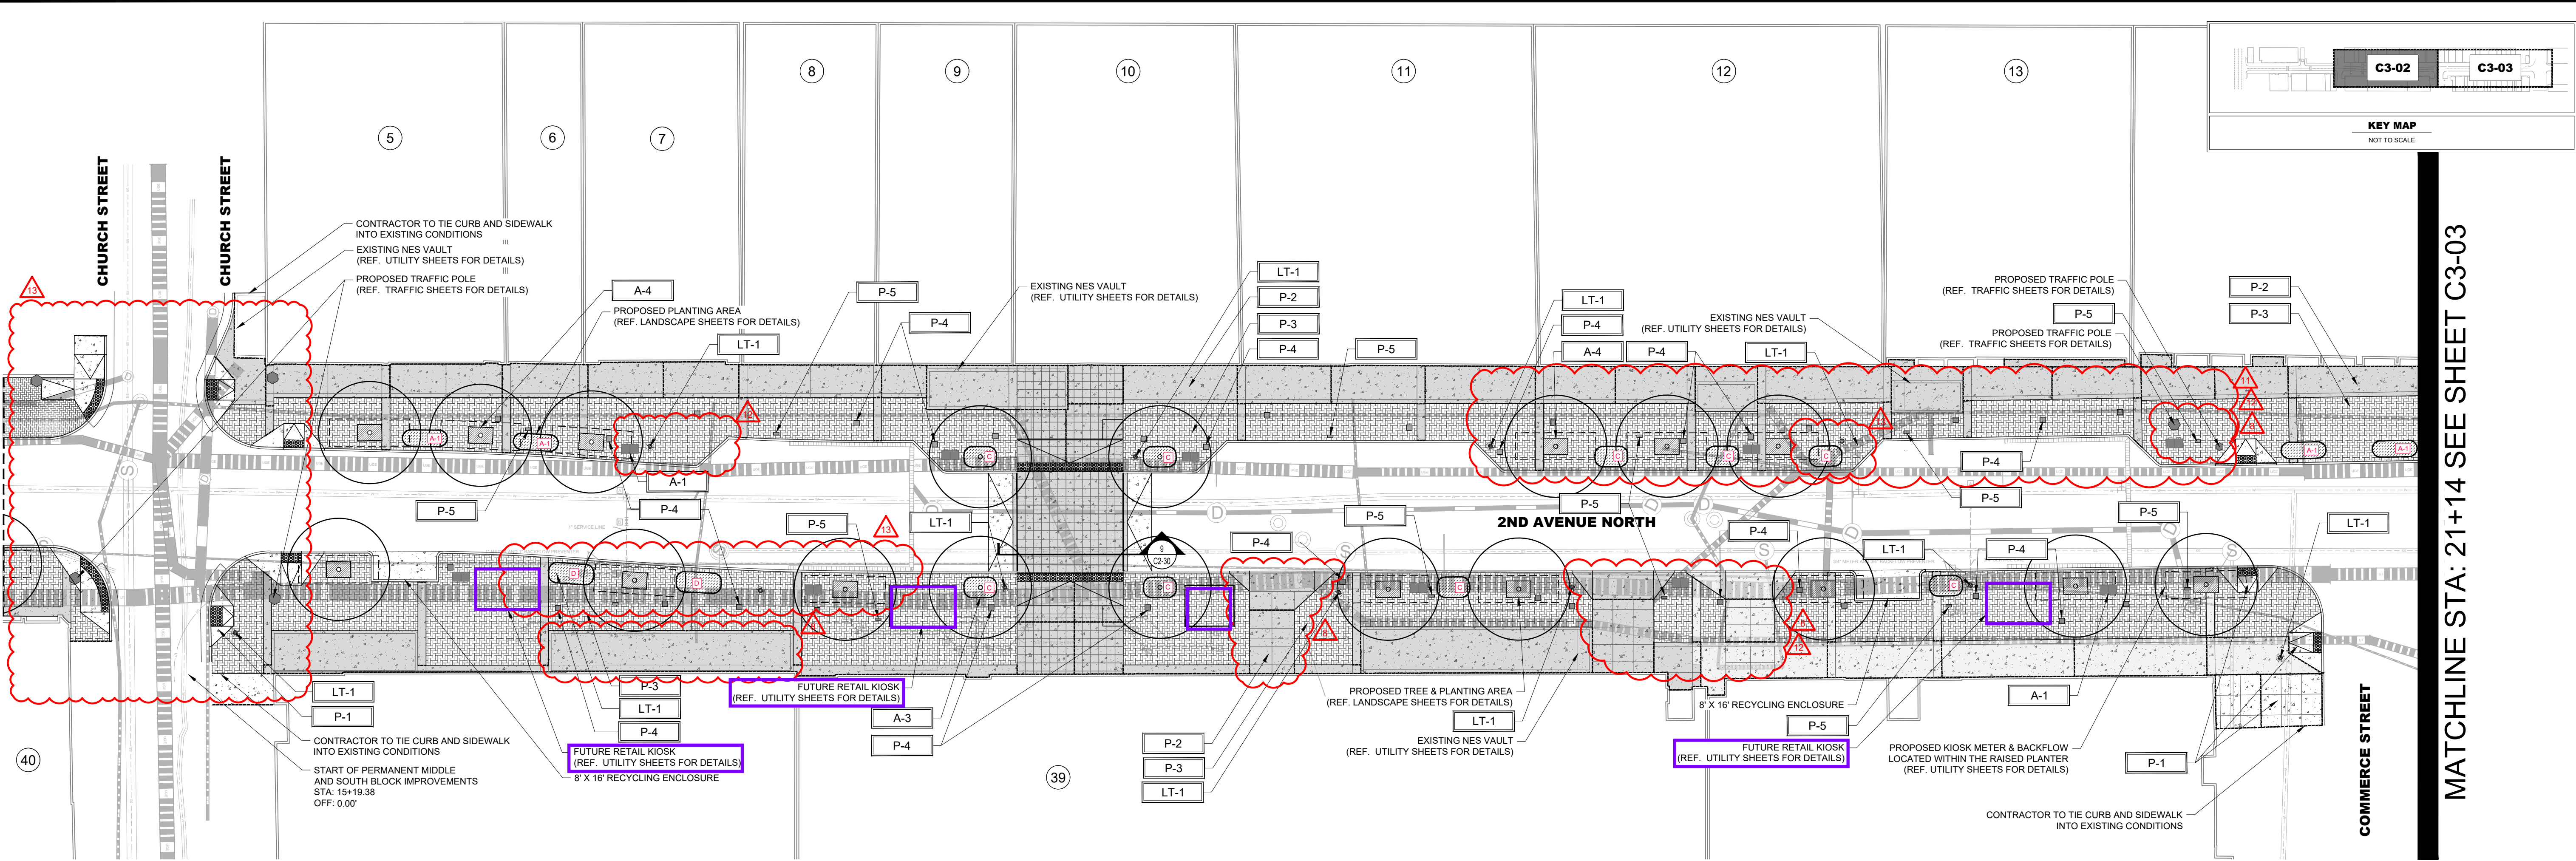



PLANTER TYPE AND QUANTITY TABLE		
PLANTER TYPE	DIMENSION	QUANTITY
A	5' X 14'	0
D	5' X 11'-3"	2
C	5' X 8'-3"	9
A-1	4' X 11'-3"	4
B	4' X 8'-3"	0

- GENERAL NOTES**
- CONTRACTOR SHALL FAMILIARIZE HIM/HERSELF WITH THE LIMITS OF WORK AND EXISTING CONDITIONS AND VERIFY ALL INFORMATION. IF DISCREPANCIES EXIST, CONTRACTOR SHALL NOTIFY OWNER'S REPRESENTATIVE IN WRITING WITHIN SEVEN DAYS OF NOTICE TO PROCEED.
 - HARDSCAPE AND LAYOUT PLAN SHEETS DO NOT INCLUDE VERTICAL DESIGN OF STREETSAPES AND ROADWAYS. REFERENCE CIVIL GRADING AND DRAINAGE DRAWINGS FOR PERTINENT INFORMATION AND SPECIFICATIONS.
 - FOR EXISTING UTILITIES TO REMAIN, INCLUDING MANHOLES, VALVE BOXES, FIRE HYDRANTS, CLEANOUTS, ETC., ADJUST TO MATCH PROPOSED GRADE PER THE CIVIL GRADING AND DRAINAGE PLANS.
 - THE CONTRACTOR WILL BE REQUIRED TO CLOSELY COORDINATE WITH ADJACENT PROPERTY OWNERS DURING CONSTRUCTION REGARDING DISRUPTION OF ACCESS FROM THE PUBLIC RIGHT-OF-WAY.

DETAIL REFERENCE TABLE				
KEY	SYMBOL	DESCRIPTION	QUANTITY	DETAIL / SHEET
P-1		STANDARD CONCRETE		#1 / C6-50
P-2		SPECIALITY CONCRETE		#1 / C6-50
P-3		CONCRETE PAVERS		#2 / C6-50
P-4		GRANITE PLAQUE (SQUARE)	35	#2 / C6-50
P-5		GRANITE PLAQUE (RECTANGLE)	12	#2 / C6-50
A-1		TRASH RECEPTACLE		#3 / C6-50
A-2		DECORATIVE CROSSWALK		#2 / C6-51
A-3		RAISED PLANTERS		#1 / C6-51
A-4		TREE GRATE W/ SOIL CELLS		#1 / C6-52
LT-1		STREET LIGHT POLE		REFERENCE LIGHTING DETAILS
		EXPANSION JOINT		#1 / C6-50
		SCORE JOINT		#1 / C6-50
		LANDSCAPE AREA		



CONSTRUCTION PLANS

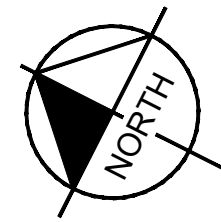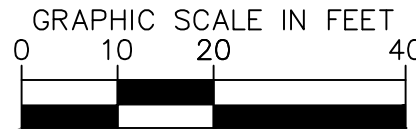

Kimley»Horn

10 Lea Avenue, Suite 400, Nashville, TN 37210
Main: 615.564.2701 | www.kimley-horn.com
© 2024 Kimley-Horn and Associates, Inc.

**2ND AVENUE NORTH
STREETSCAPE -
MIDDLE AND SOUTH BLOCKS**

NASHVILLE, TN

SUMMARY OF REVISIONS		BY		DATE		REVISIONS	
No.	REVISIONS	No.	BY	DATE	REVISIONS	No.	BY
1	REVISION 1	8/4/2023	ZJD	12/16/2024	ZJD		
2	REVISION 2	8/25/2023	ZJD	12/23/2025	ZJD		
3	REVISION 3	10/31/2023	ZJD	13/32/2025	ZJD		
4	REVISION 4	1/31/2024	ZJD				
6	REVISION 6	4/11/2024	ZJD				
7	REVISION 7	5/6/2024	ZJD				
8	REVISION 8	8/1/2024	ZJD				
9	REVISION 9	9/6/2024	ZJD				
10	REVISION 10	10/22/2024	ZJD				

DESIGNED BY: AKG

DRAWN BY: AKG

CHECKED BY: JLR

DATE: 3/25/2025

KIMLEY-HORN PROJECT NO. 118900012

DETAIL MATERIAL
CALLOUT PLAN -
MIDDLE BLOCK

SHEET NUMBER
C3-02